


FIELD

CONTROL ROOM

N/C METERING CABINET

LOGIC BOX

FCS

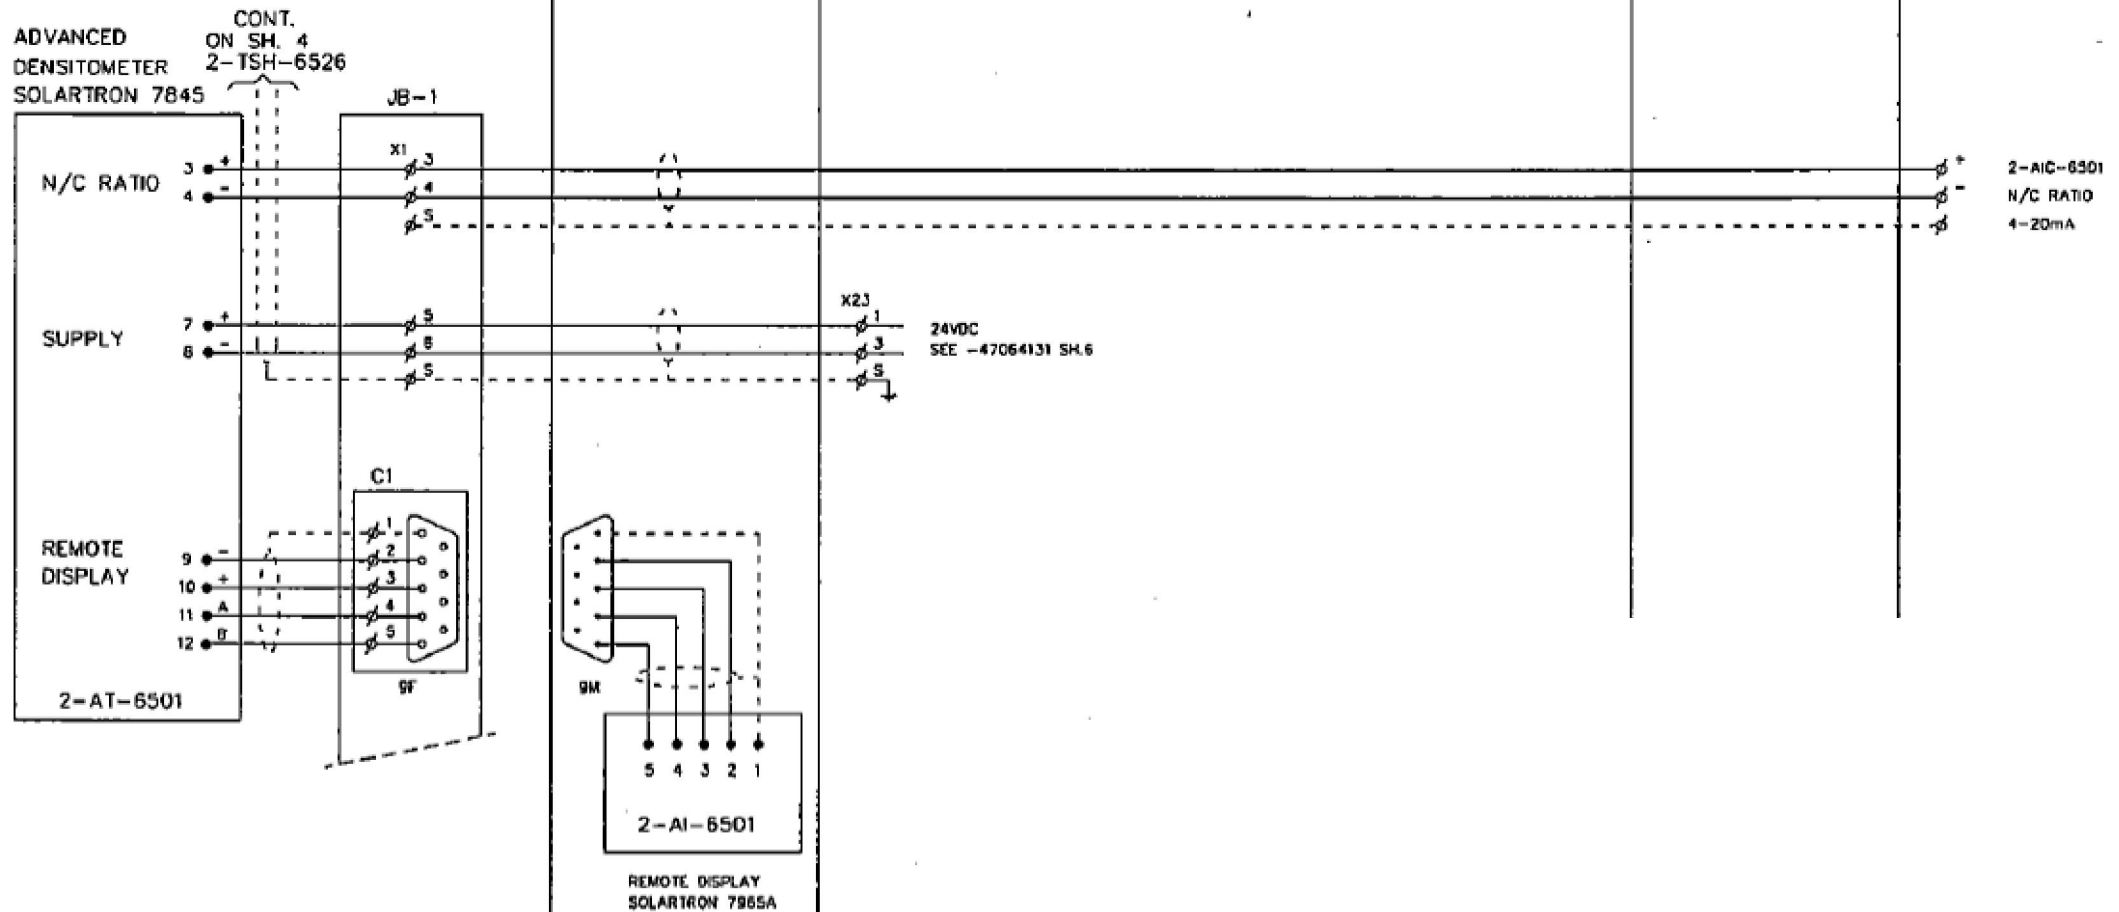

| REV. | DATE | DESCRIPTION | CHK'D | APP'D |
|------|-------|------------------|-------|--------|
| B | 01-05 | AS BUILT | | M.H.B. |
| A | 09-04 | FOR CONSTRUCTION | | M.H.B. |
| - | 08-04 | FIRST ISSUE | | M.H.B. |

| | | | |
|---|-----------|------|------|
| <p>Partners 85 8200 28 West Street Beverly Hills E-mail: info.roland@amecspie.com</p> | DRWG. NO. | SHT. | REV. |
| | 47064100 | 1 | B |